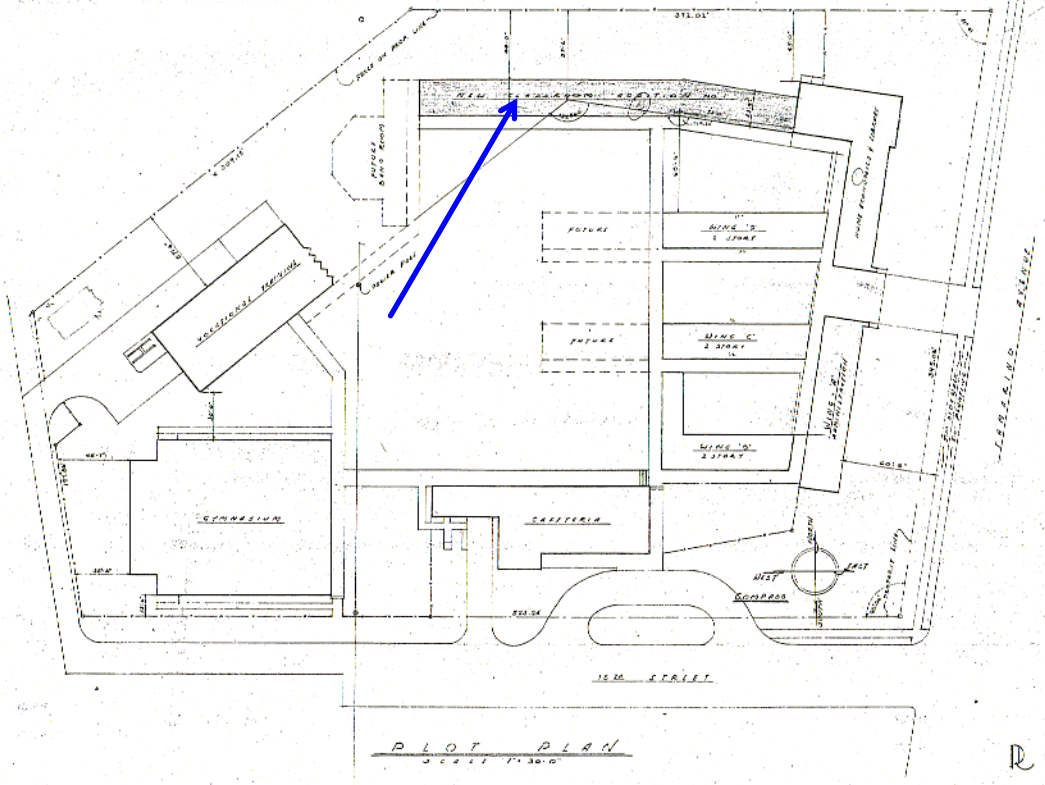

PLOT PLAN
SCALE 1"=30'-0"

Project 2441-9943

SHEET SCHEDULE

SHEET NO	DESIGNATION
101	PLOT PLAN
102	FOUNDATION PLAN & SECTIONS
103	STRUCTURAL SECTIONS
104	STRUCTURAL SECTIONS
105	FIRST FLOOR PLAN
106	SECOND FLOOR PLAN
107	ELEVATIONS
108	TYPICAL CLASSROOM DETAILS
109	TOILET ROOMS & PIPE RAILING
110	SEWAGE & WATER SERVICE
111	FIRST FLOOR PLUMBING PLAN
112	SECOND FLOOR PLUMBING PLAN
113	FIRST FLOOR ELECTRIC PLAN
114	SECOND FLOOR ELECTRIC PLAN
115	FIRST FLOOR HEATING PLAN
116	SECOND FLOOR HEATING PLAN

ADDITION NO. 1
ROOSEVELT JR. HIGH SCHOOL
WEST PALM BEACH, FLORIDA

Four classrooms downstairs, 3 upstairs and 2 restrooms were damaged by Hurricanes Frances and Jeanne, as well as the roof and the second story walkway cover.
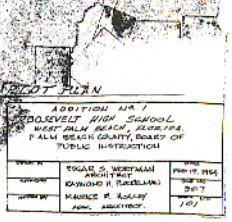
Project: # 2441-0061
School Name: Roosevelt Full Service
Year: 1956
Document: As Built